STATE	PROJECT NUMBER	SHEET NUMBER	TOTAL SHEETS
GEORGIA	BRZLB-77(37)	91	113

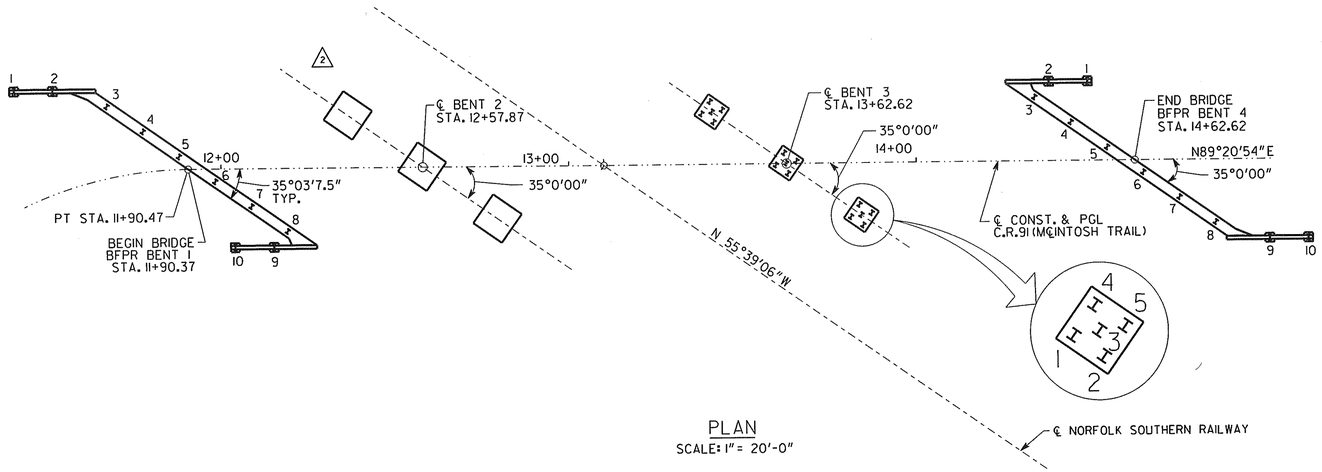

PLAN
SCALE: 1" = 20'-0"

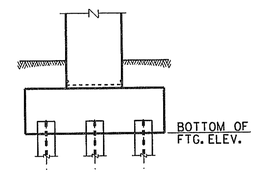

AS-BUILT FOUNDATION INFORMATION			
BENT	PILE LOCATION	PILE NO.	PILE TIP ELEVATION
1	LT. WINGWALL	1	887.10
	LT. WINGWALL	2	888.60
	BEAM 1	3	890.30
	BEAM 2	4	888.54
	BEAM 3	5	885.55
	BEAM 4	6	884.56
	BEAM 5	7	883.87
	BEAM 6	8	882.63
	RT. WINGWALL	9	884.19
	RT. WINGWALL	10	883.09

AS-BUILT FOUNDATION INFORMATION		
BENT	LOCATION	BOTTOM OF FTG. ELEV.
2	FTG. COL 1	884.00
	FTG. COL 2	884.00
	FTG. COL 3	883.69

AS-BUILT FOUNDATION INFORMATION				
BENT	PILE LOCATION	BOTTOM OF FTG. ELEV.	PILE NO.	PILE TIP ELEVATION
3	FTG. COL 1	887.75	1	868.70
			2	869.90
			3	869.40
			4	867.30
			5	869.15
	FTG. COL 2	887.75	1	867.50
			2	870.50
			3	867.50
			4	869.50
			5	867.50
	FTG. COL 3	887.75	1	873.50
			2	866.66
			3	865.75
			4	865.05
			5	867.25

AS-BUILT FOUNDATION INFORMATION			
BENT	PILE LOCATION	PILE NO.	PILE TIP ELEVATION
4	LT. WINGWALL	1	869.34
	LT. WINGWALL	2	864.59
	BEAM 1	3	867.92
	BEAM 2	4	869.92
	BEAM 3	5	872.75
	BEAM 4	6	870.50
	BEAM 5	7	869.08
	BEAM 6	8	868.92
	RT. WINGWALL	9	871.67
	RT. WINGWALL	10	873.75

NOTE:
THIS "AS-BUILT INFORMATION SHEET IS TO BE FILLED IN BY THE PROJECT ENGINEER AND FORWARDED TO THE BRIDGE OFFICE AFTER INSTALLATION OF ALL PILES FOR POSTING TO THE PLANS AS A PERMANENT RECORD OF THE BRIDGE CONSTRUCTION.

GEORGIA REGISTERED 19039 PROFESSIONAL ENGINEER HISHAM H. DEEB

USE ON CONSTRUCTION

BRIDGE NO-1

Moreland Altobelli Associates, Inc.
2211 Beaver Ruin Road Suite 190
Norcross, Georgia 30071
Tel.: (770) 263-5945

	NAME		NAME		NAME
DESIGNED BY	RS	DRAWN BY	SSB	QUANTITIES BY	
CHECKED BY	RYS	CHECKED BY	FEJ	CHECKED BY	
SUPERVISED BY	HISHAM H. DEEB, P.E.			DATE: SEPTEMBER 2001	

DEPARTMENT OF TRANSPORTATION
STATE OF GEORGIA

REVISIONS			
△	DATE	BY	
2	03/05/04	FEJ	REVISED FOUNDATION INTERMEDIATE BENT 2
2	6/19/08	KWK	AS BUILT DATA ADDED

AS-BUILT FOUNDATION DATA
C.R. 91 (McINTOSH TRAIL) OVER NORFOLK SOUTHERN RAILWAY
COWETA COUNTY BRZLB-77(37)

DRAWING NUMBER 16 OF 17