STATE	PROJECT NUMBER	SHEET NO.	TOTAL SHEETS
GA.	TSAP 193(9)	48	135

Added Sheet 1-24-83
DELETED 5-19-83

~~TYPICAL SECTION~~

~~SECTION NO. 2 ALTERNATE "B"~~

DELETE ON CONSTRUCTION

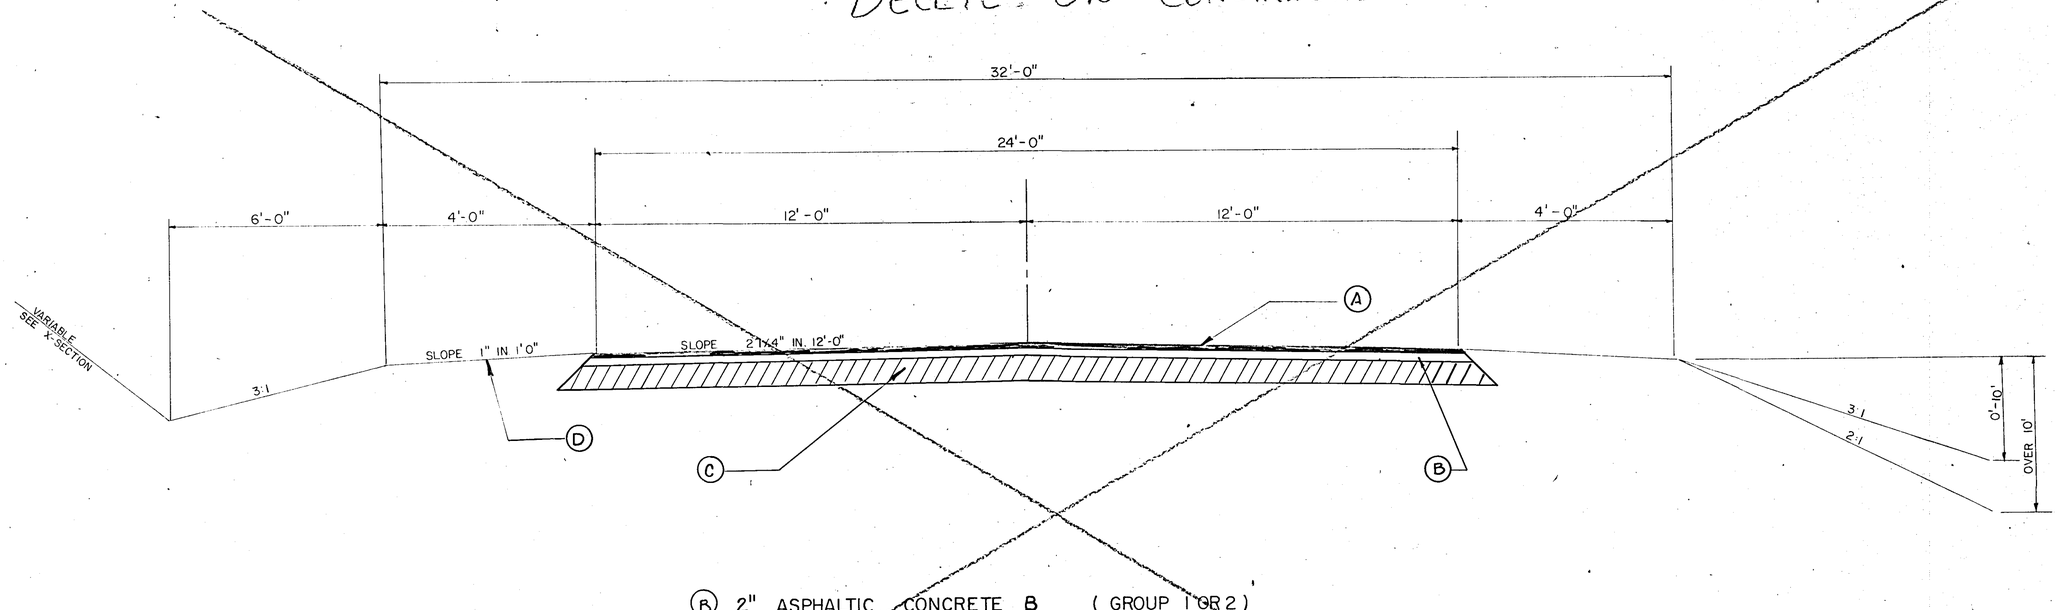

(B) 2" ASPHALTIC CONCRETE B (GROUP 1 OR 2)
(C) 8" GRADED AGGREGATE BASE
(A) ASPHALTIC CONCRETE "F" (135 LBS. PER SQ. YD.) (BLEND 1)
(D) UNCLASSIFIED SHOULDERS
BITUMINOUS TACK COAT

NOTE: RECOMMEND-PAVEMENT CUTS FOR REPLACING INADEQUATE CROSS DRAIN PIPES BE REPAIRED IN ACCORDANCE WITH THE CONSTR. DET. "STORM DRAIN AND UTILITY INSTALLATIONS BY OPEN CUT ACROSS EXISTING PAVEMENT", WHERE THE EXISTING PAVEMENT IS TO BE RETAINED.

TYPICAL SECTION FOR DETOUR

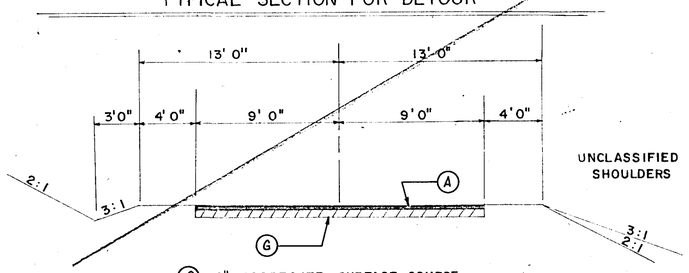

(G) 6" AGGREGATE SURFACE COURSE
(A) ASP. CONC. "F" 110 LBS/SQ. YD.

NO SCALE

SERRATED SLOPE DETAIL

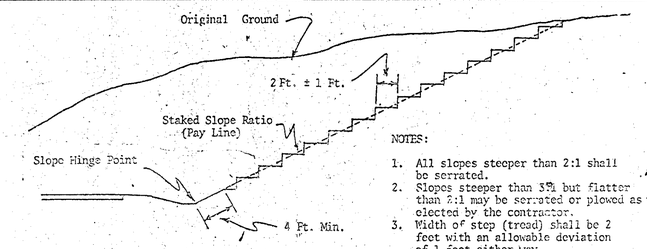

Not to Scale

NOTES:

1. All slopes steeper than 2:1 shall be serrated.
2. Slopes steeper than 3:1 but flatter than 2:1 may be serrated or plowed as elected by the contractor.
3. Width of step (tread) shall be 2 feet with an allowable deviation of 1 foot either way.
4. Height of step (rise) is a function of width of step and staked slope ratio.
5. Tread of step to be approximately horizontal.

TYPICAL SECTION NO. 2 APPLICABLE FROM:

STATION	TO	STATION
173+00	-	179+00
187+00	-	190+00
198+50	-	202+50
245+50	-	252+75
269+50	-	282+00
308+00	-	315+00
325+00	-	330+00