STATE	PROJECT NUMBER	SHEET NO.	TOTAL SHEETS
GA	TSAP 193(9)	96	135

Rev 5-19-83

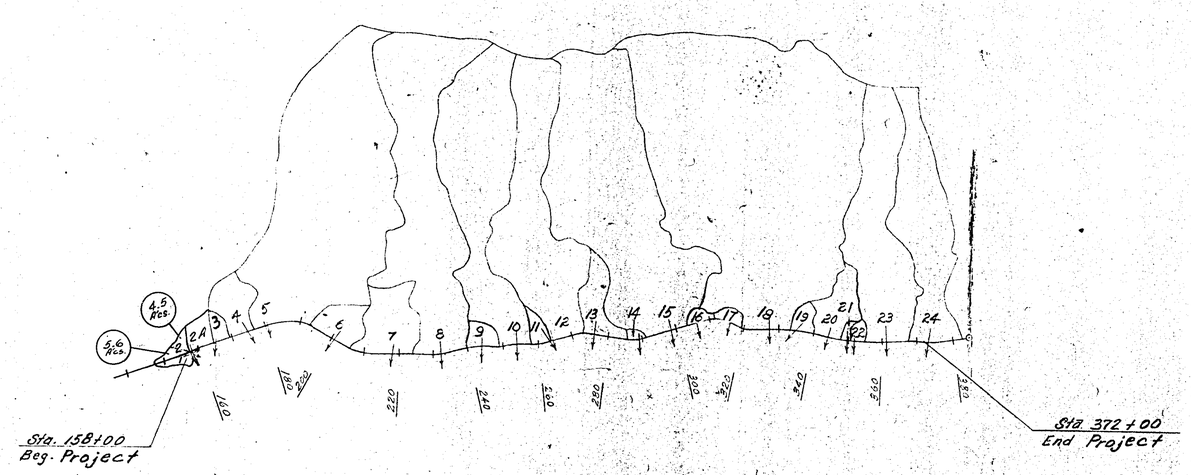

DRAINAGE SCHEDULE								
NO.	STA.	SKEW	AREA		DESCRIPTION	Q50	Q100	
3	165+50	60° Lt.	8.3		18"	13	15	
4	174+75	82°30' Rt.	36.7		36"	61	70	
5	180+50	60°00' Lt.	558.3		Dbl. 6'x5' Clvt.	475	550	
6	200+67	80°00' Lt.	31.2		36"	56	64	
7	218+22	82°30' Lt.	64.3		48"	105	125	
8	231+94	90°	360.0		~~9'x5' Box Clvt.~~	345	405	DBL. 60" *
9	243+90	90°	13.8		30"	33	38	
10	253+89	90°	293.8		~~6'x6' Box Clvt.~~	305	355	DBL. 60" *
11	264+28	90°	288.3		~~9'x5' Box Clvt.~~	300	350	DBL. 60" *
13	276+02	90°	41.3		42"	67	77	
14	289+29	90°	3.7		24"	13	15	
15	298+40	90°	493.1		~~7'x7' Box Clvt.~~	430	510	DBL. 60" *
16	305+98	90°	6.4		24"	20	23	
17	315+72	82°00' Rt.	7.3		24"	23	26	
18	327+35	90°	950.4		Dbl. 9'x6' Box Clvt.	690	800	
19	335+05	60°00' Lt.	11.0		30"	28	32	
20	345+45	90°	41.3		42"	67	77	
21	349+95	90°	4.6		24"	16	18	
22	351+75	90°	6.4		24"	20	23	
23	361+00	90°	217.6		~~Dbl. 4'x4' Box Clvt.~~	250	290	DBL. 54" *
1	158+15-159 Rt.		5.5		24"	18	21	
2	158+65	33°45' Rt.	10.1		30"	29	33	
2A	159+72	60° Rt.	14.7		36"	45	52	

* USE ON CONSTR.

DEPARTMENT OF TRANSPORTATION
TSAP 193(9) WALKER COUNTY
CHATTANOOGA VALLEY ROAD
SR-193
DRAINAGE MAP

SCALE 1" = 2000' SHEET 1 OF 1

April '77

Dietzgen N. D. 190M "Approof"