STATE	PROJECT NUMBER	SHEET NO.	TOTAL SHEETS
GA.	F-017-3(39)	25A ~~284~~	194

Rev. ~~3-13-87~~ 5-22-87
Added to Plans

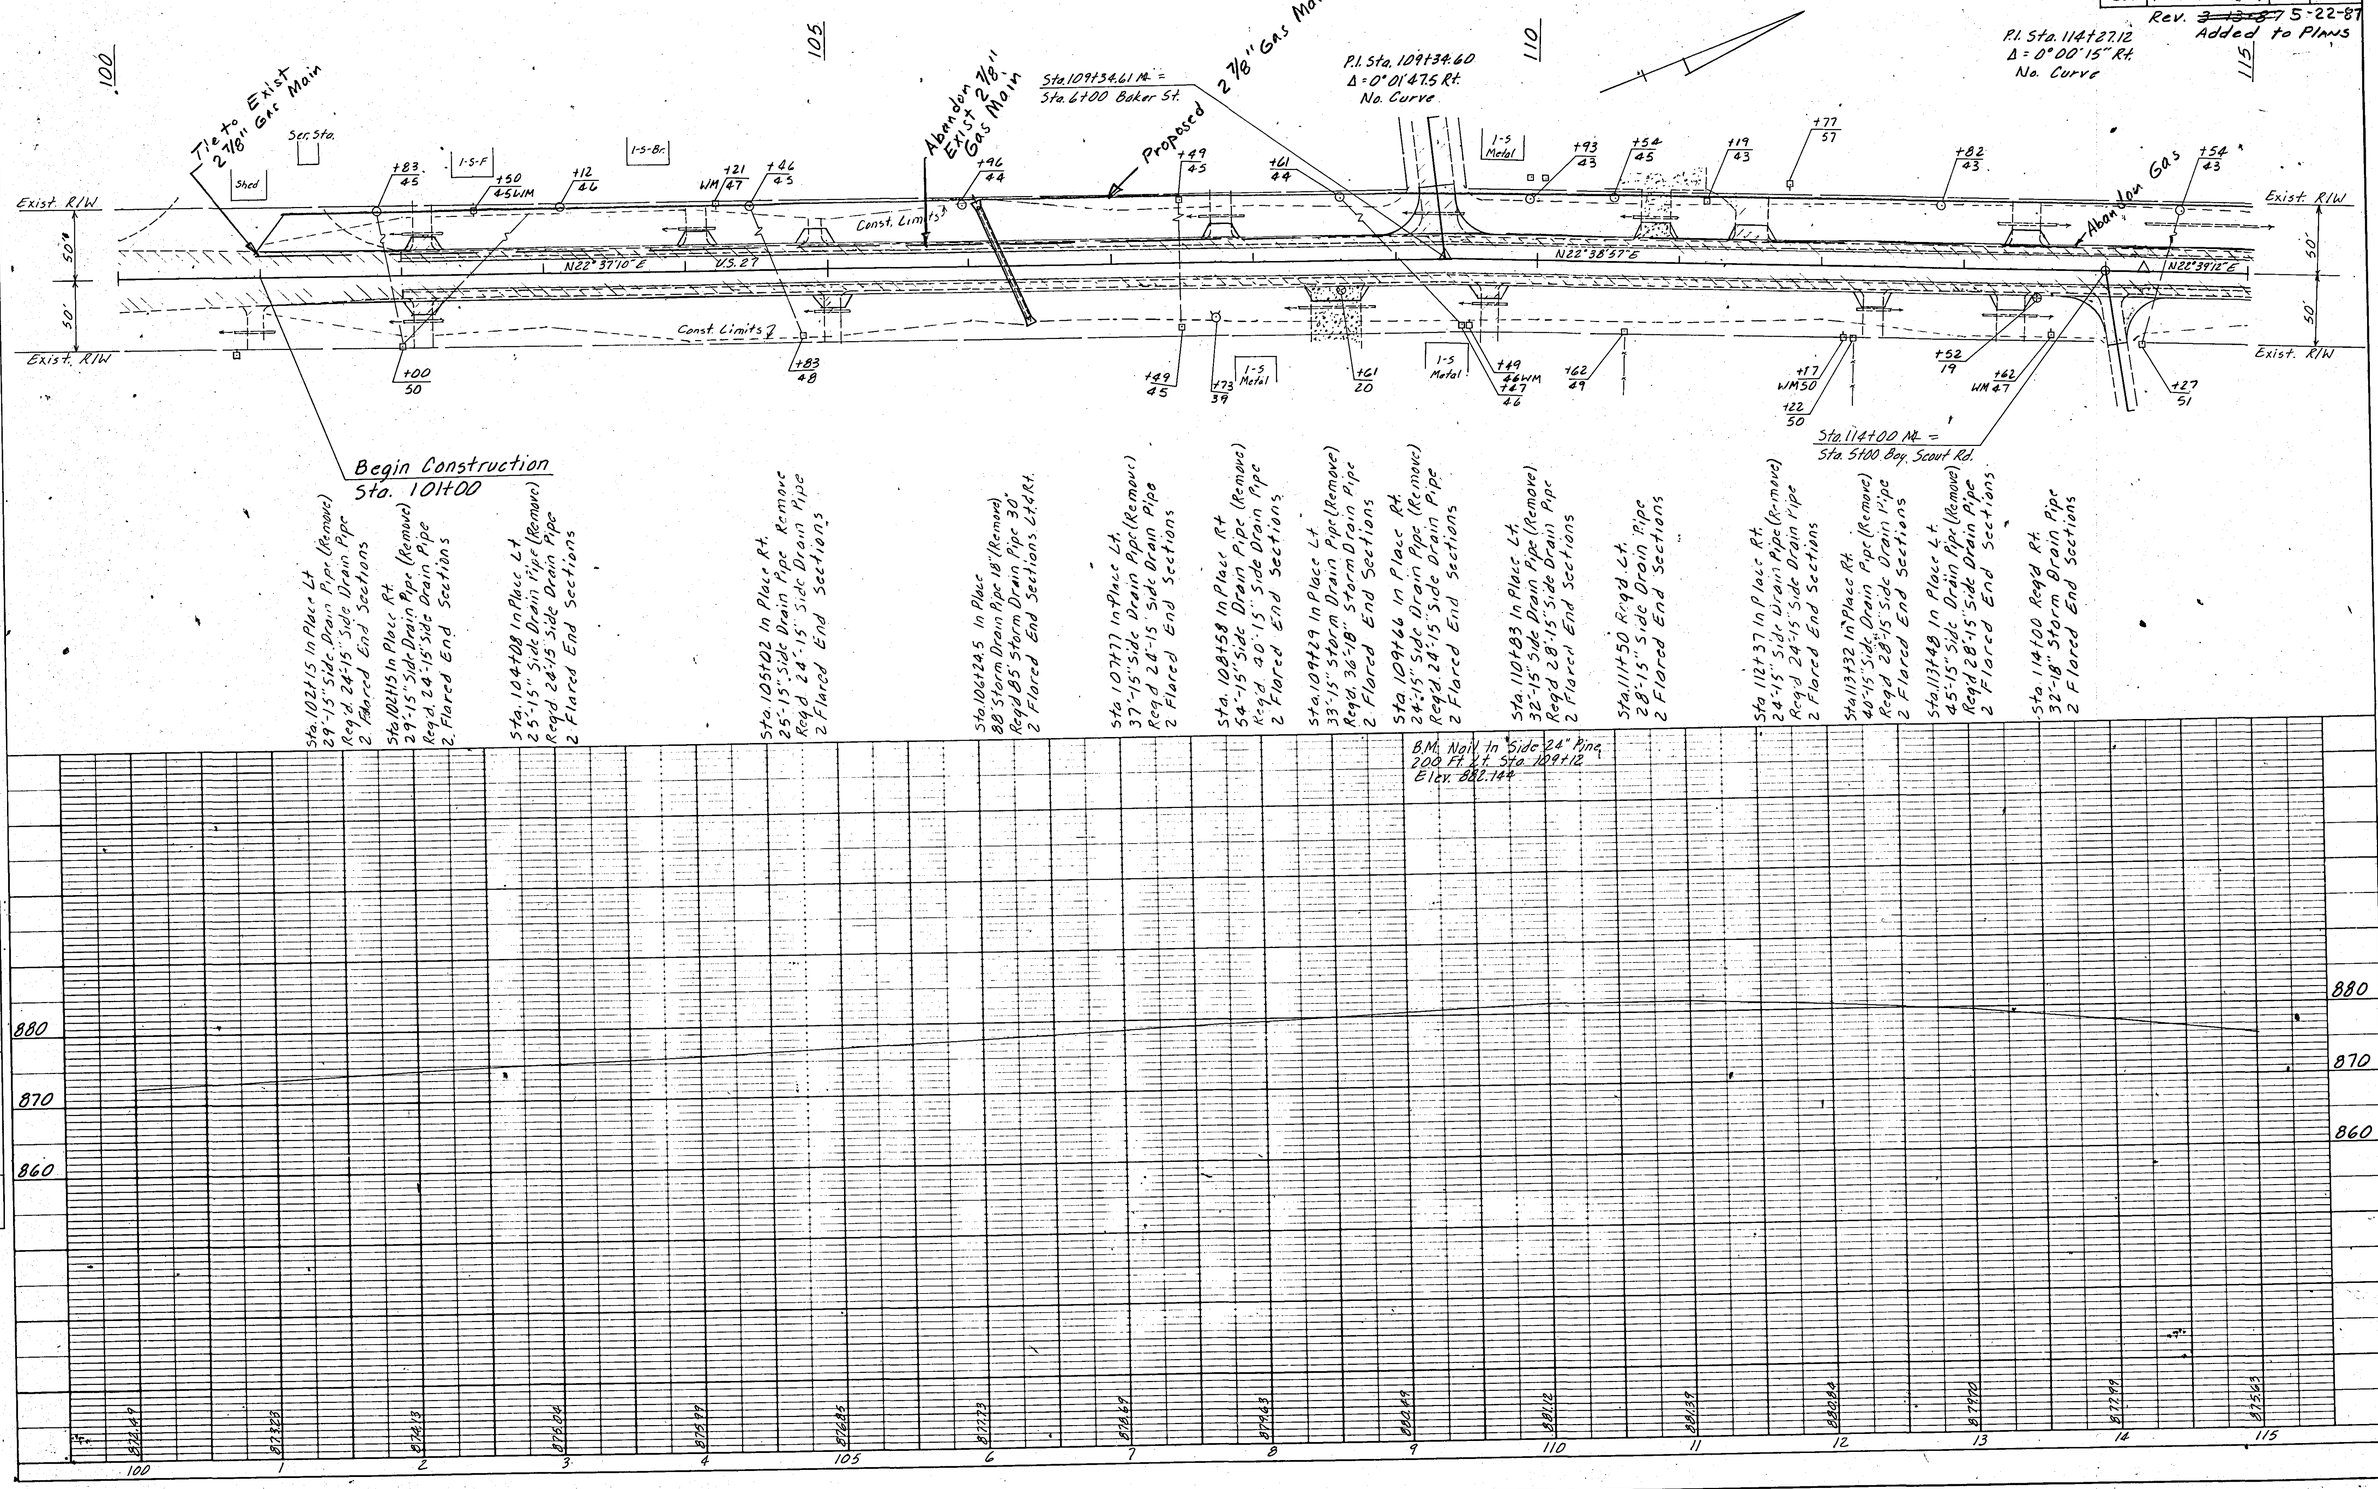

PLAN	SURVEYED	PLOTTED	ALIGNMENT CHECKED	RE-SURVEY CHECKED	DATE
NOTE BOOK					
No.					

PROFILE	SURVEYED	PLOTTED	GRADES CHECKED	STRUCTURE NOTATIONS CHECKED	DATE
NOTE BOOK					
No.					

Form No. EF 00001