STATE	PROJECT NUMBER	SHEET NO.	TOTAL SHEETS
GA.	F-017-3 (39)	92B ~~288~~	194

Rev. ~~3-18-87~~ 5-22-87
Added to PLANS

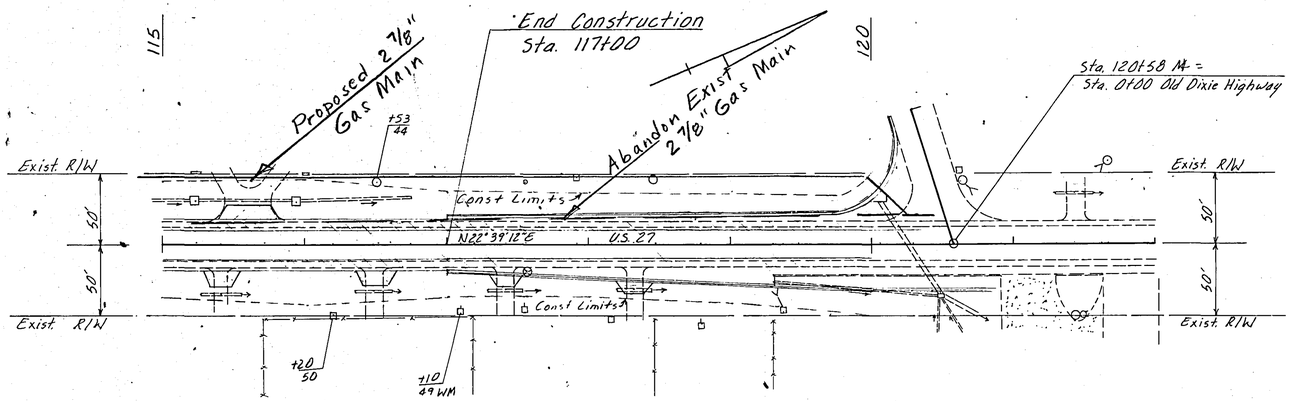

Note: Adjust Plans And Quantities For Project F-017-3(39) At Sta. 117+00 For Req'd Typical Section OF U.S. 27.

Sta. 114+85 - 116+75 In Place Lt.
190'-15" Side Drain Pipe
2 6'X6' Drop Inlets (Retain)
Req'd. 2 Flared End Sections

Sta. 115+41 In Place Rt.
28'-15" Side Drain Pipe (Remove)
Req'd. 24'-15" Side Drain Pipe
2 Flared End Sections

Sta. 116+47 In Place Rt.
28'-15" Side Drain Pipe Remove
Req'd. 24'-15 Side Drain Pipe
2 Flared End Sections

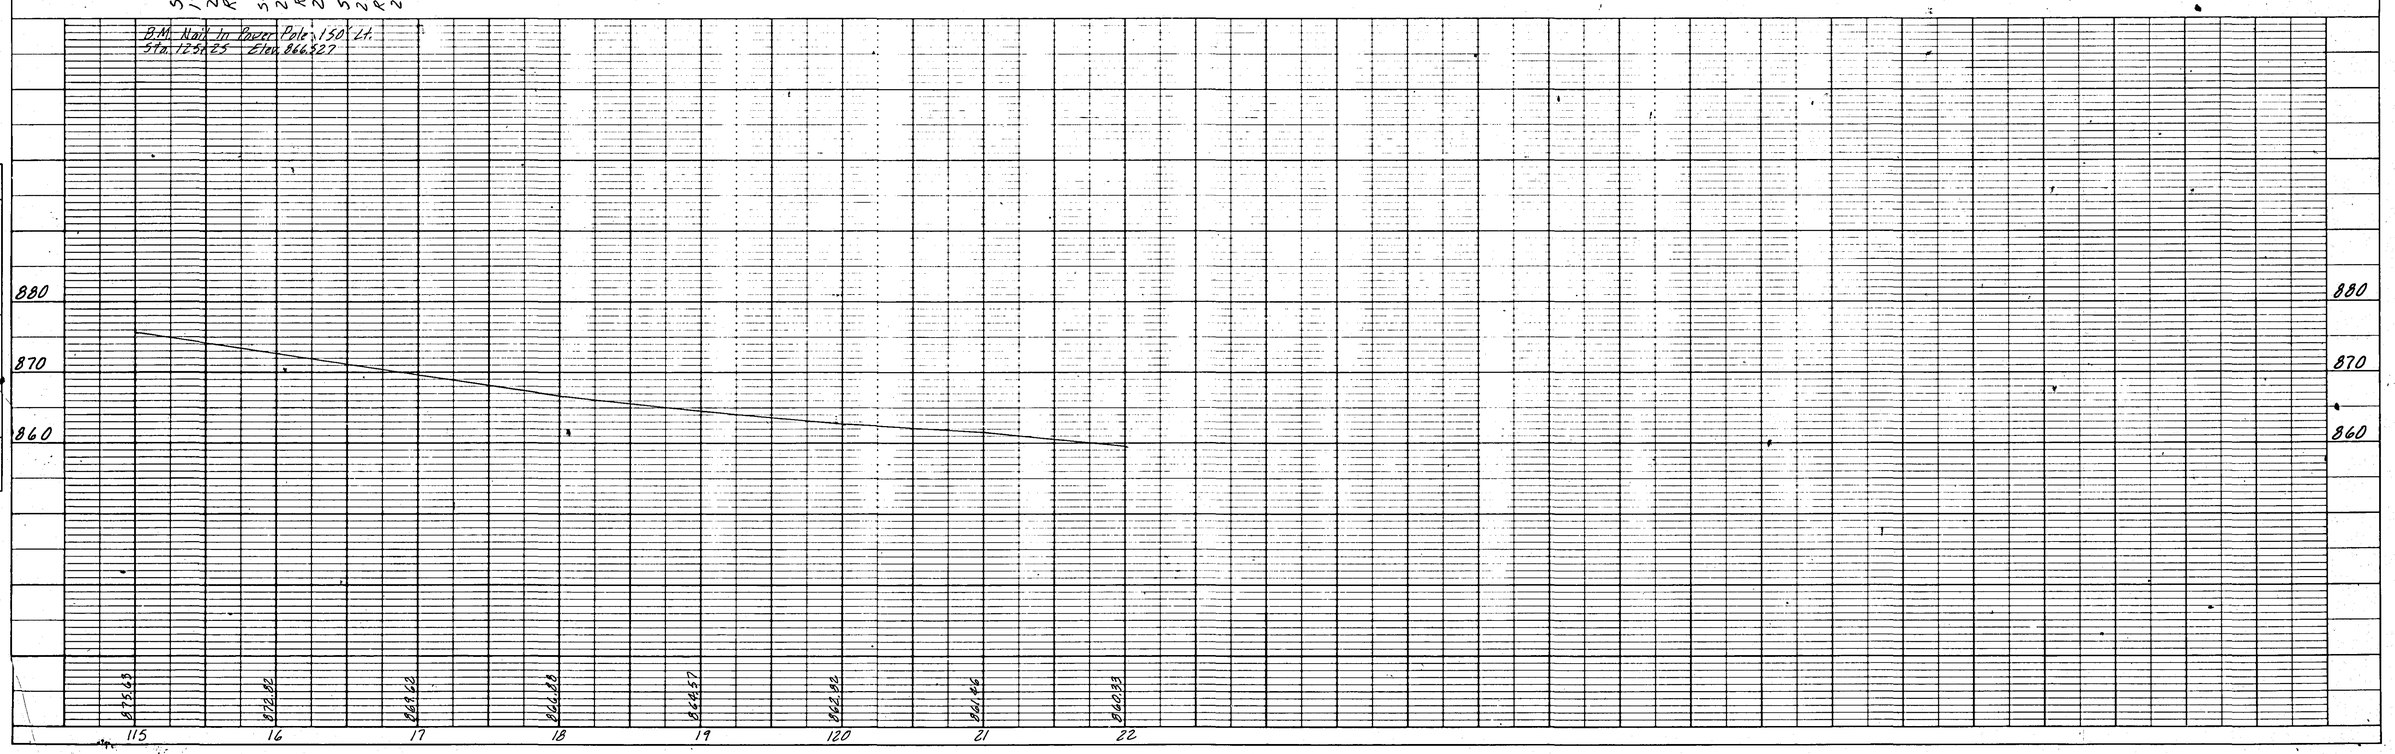

PLAN
NOTE BOOK
No.
SURVEYED
PLOTTED
ALIGNMENT CHECKED
RT. OF WAY CHECKED
BY
DATE

PROFILE
NOTE BOOK
No.
SURVEYED
PLOTTED
GRADES CHECKED
B.M.'s NOTED
STRUCTURE NOTATIONS CHECKED
BY
DATE

Form No. EF 00001