DATE$$$	TIME$$$	PRF	DGN	STATE	PROJECT NUMBER	SHEET NO.	TOTAL SHEETS
$USER$		$$PENTABLE$$		GA	NH000-0085-021(533)	48	480

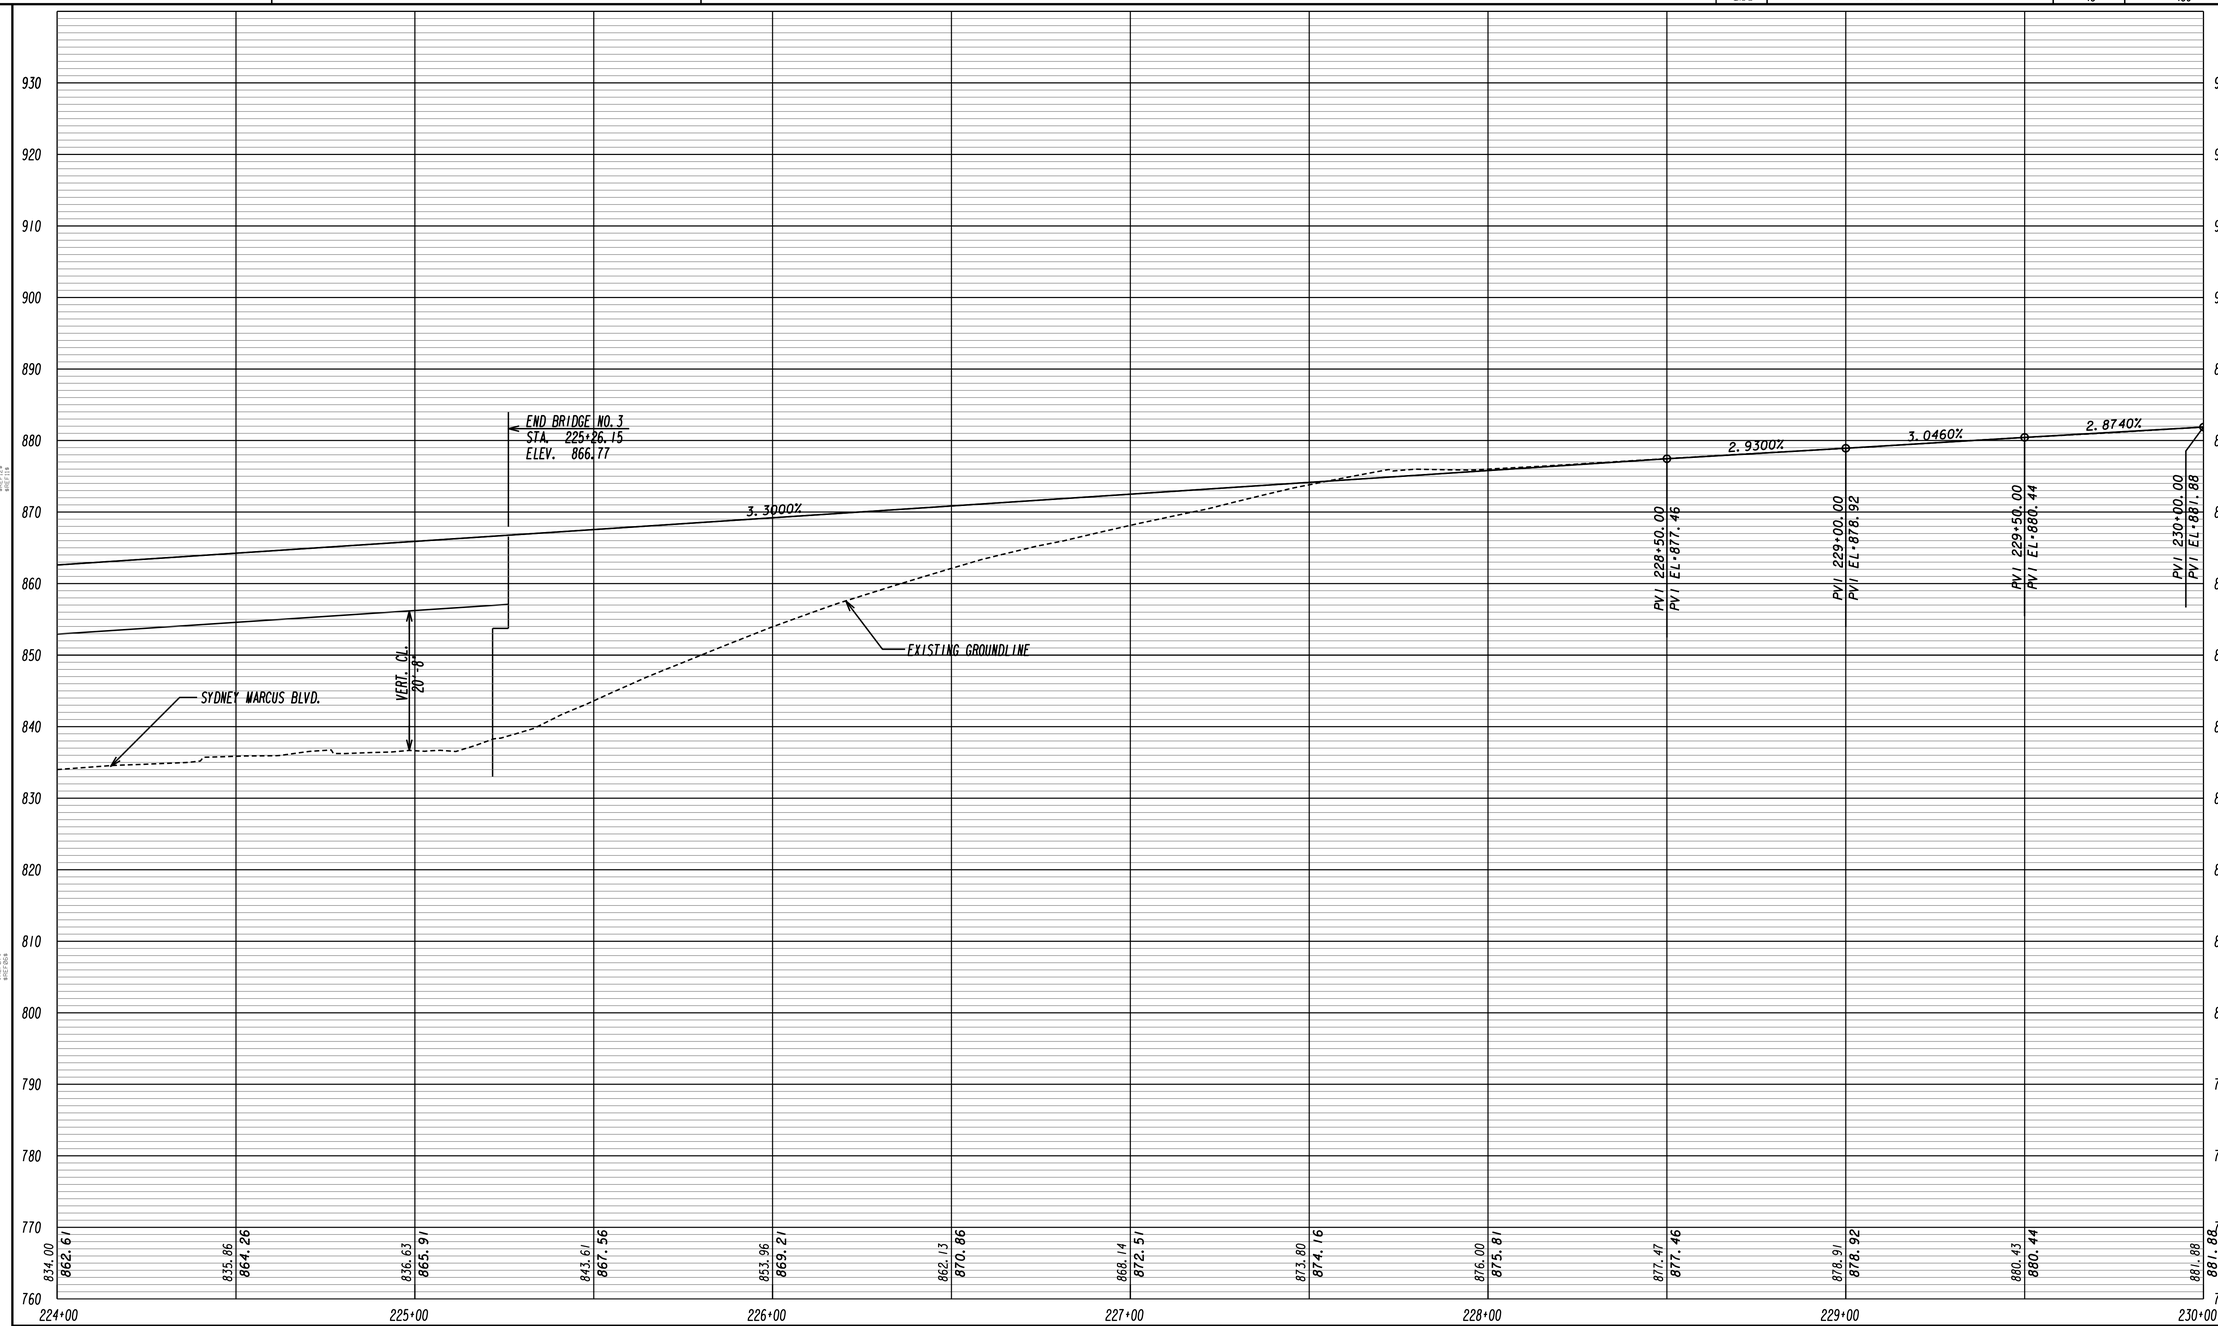

Archer Western Contractors

Heath & Lineback Engineers INCORPORATED
2390 CANTON ROAD, BUILDING 200
MARIETTA, GEORGIA 30066-5393
(770)424-1668

SCALE 1 inch = 10 feet Vert.
SCALE 1 inch = 20 feet Horiz.

AS-BUILT

REVISION DATES

STATE OF GEORGIA
DEPARTMENT OF TRANSPORTATION

OFFICE: INNOVATIVE PROGRAM DELIVERY

MAINLINE PROFILE

S.R. 400/ I-85
CONNECTOR RAMPS

DRAWING No. 15-013

3/1/2007 G20EDG