DATE$$$ TIME$$$ PRF DGN
$USER$ $$PENTABLE$$

STATE	PROJECT NUMBER	SHEET NO.	TOTAL SHEETS
GA	NH000-0085-02(153)	54	480

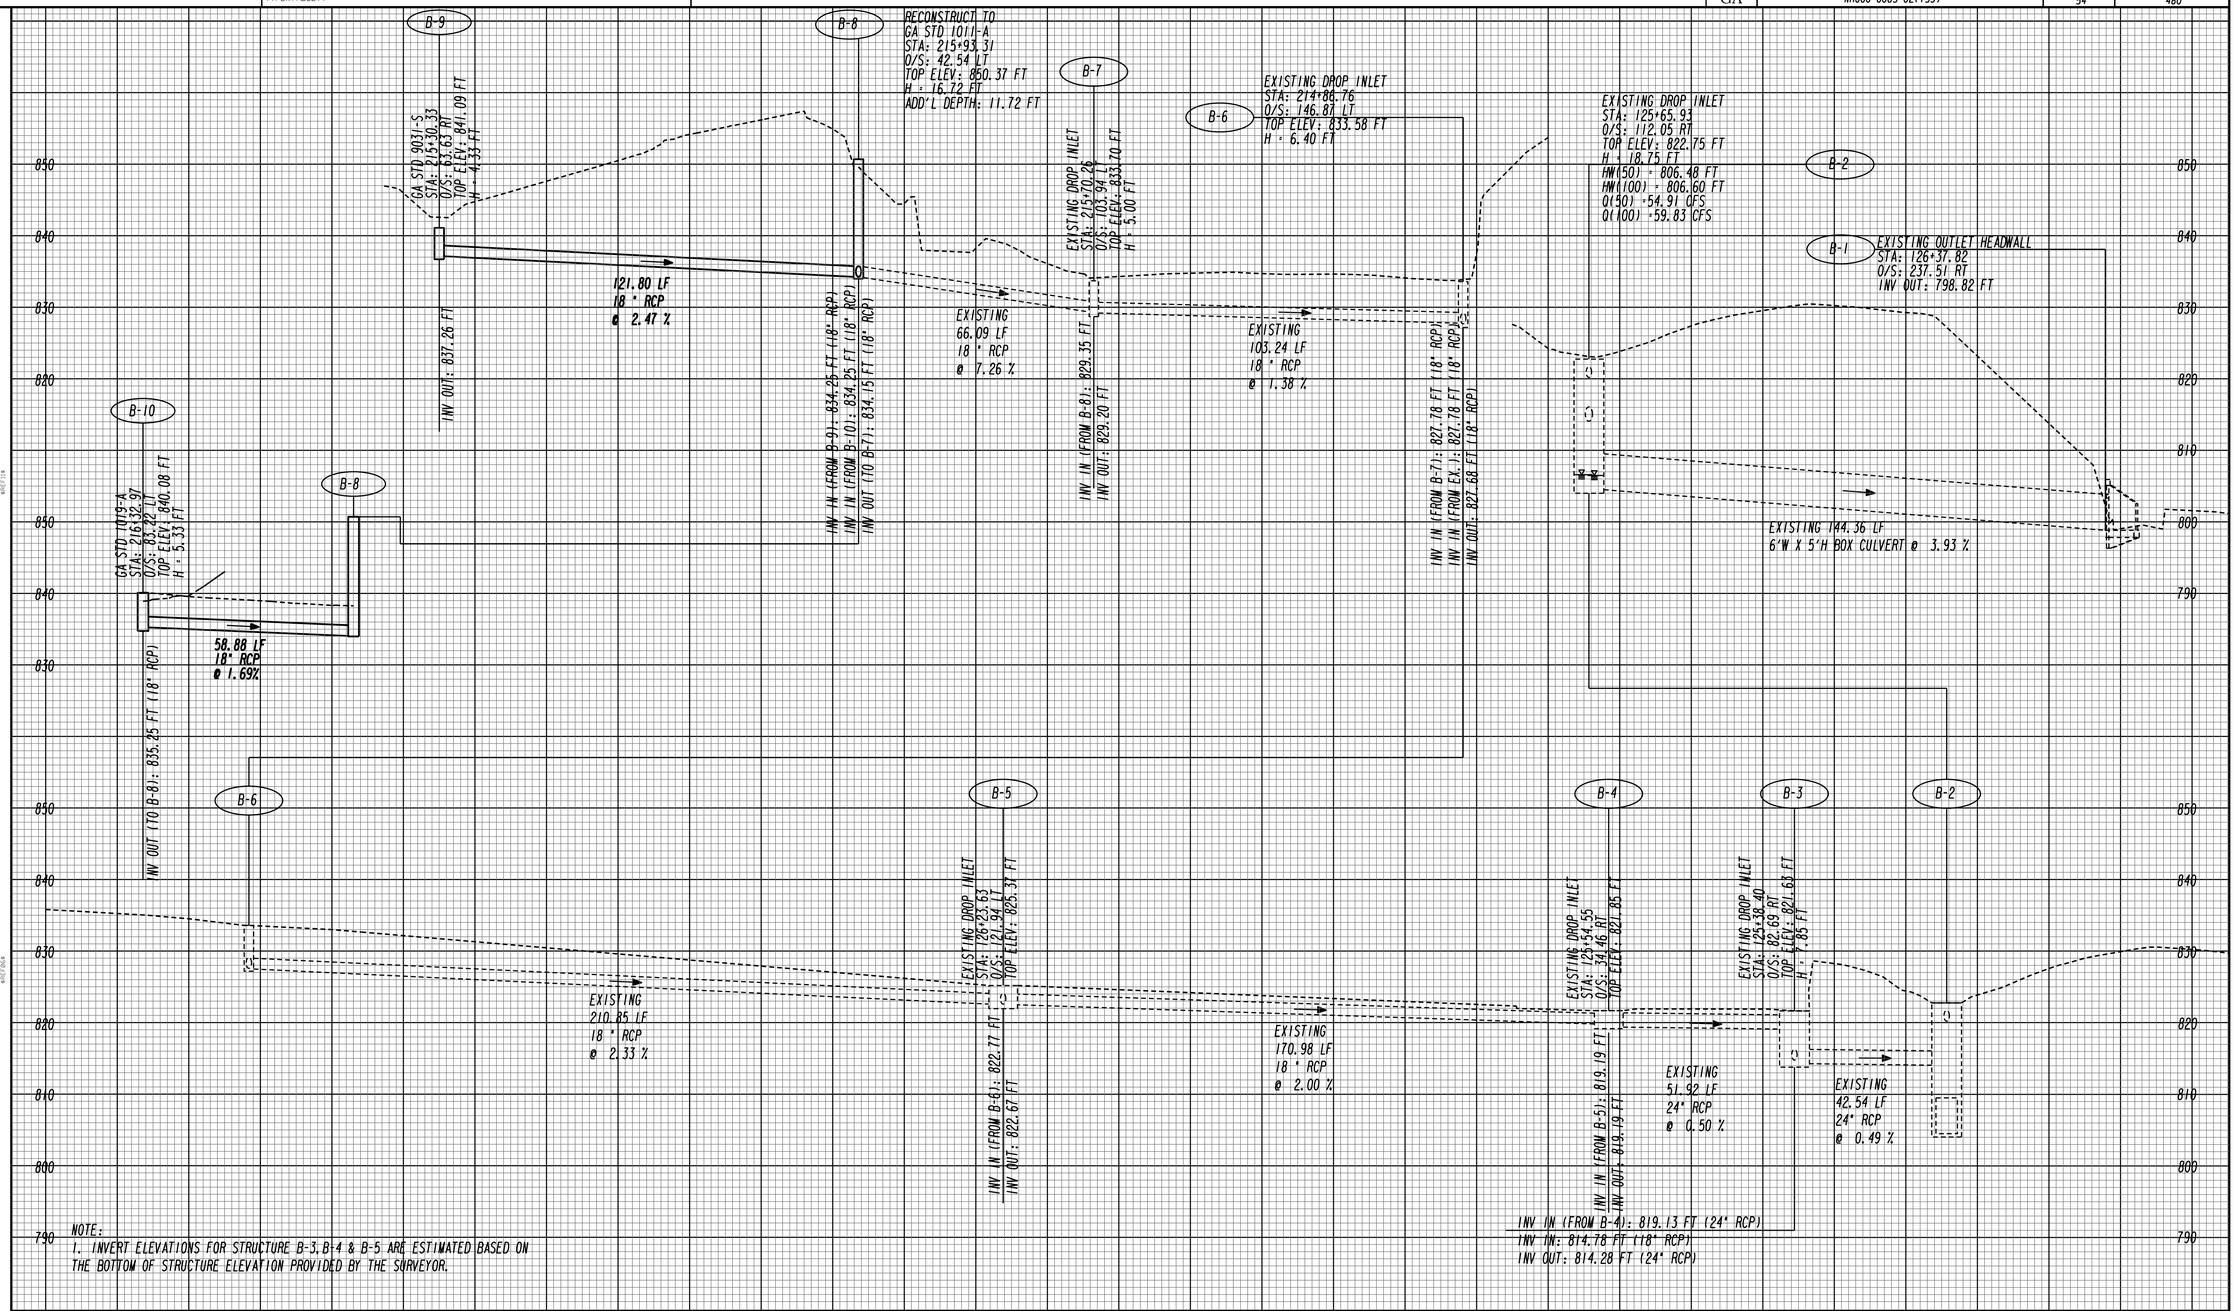

NOTE:
1. INVERT ELEVATIONS FOR STRUCTURE B-3, B-4 & B-5 ARE ESTIMATED BASED ON THE BOTTOM OF STRUCTURE ELEVATION PROVIDED BY THE SURVEYOR.

Archer Western Contractors

Heath & Lineback Engineers
INCORPORATED
2390 CANTON ROAD, BUILDING 200
MARIETTA, GEORGIA 30066-5393
(770)424-1668

HORIZONTAL SCALE: 1" = 20'
VERTICAL SCALE: 1" = 10'

AS-BUILT

REVISION DATES

STATE OF GEORGIA
DEPARTMENT OF TRANSPORTATION
OFFICE: INNOVATIVE PROGRAM DELIVERY

DRAINAGE PROFILES

S.R. 400/ I-85
CONNECTOR RAMPS

DRAWING No. 22-005

3/1/2007 SUXSEW