DATE$$$	TIME$$$	PRF	DGN	STATE	PROJECT NUMBER	SHEET NO.	TOTAL SHEETS
$USER$		$$PENTABLE$$		GA	NH000-0085-02(153)	84	480

MATCH LINE DRAWING 24-14A

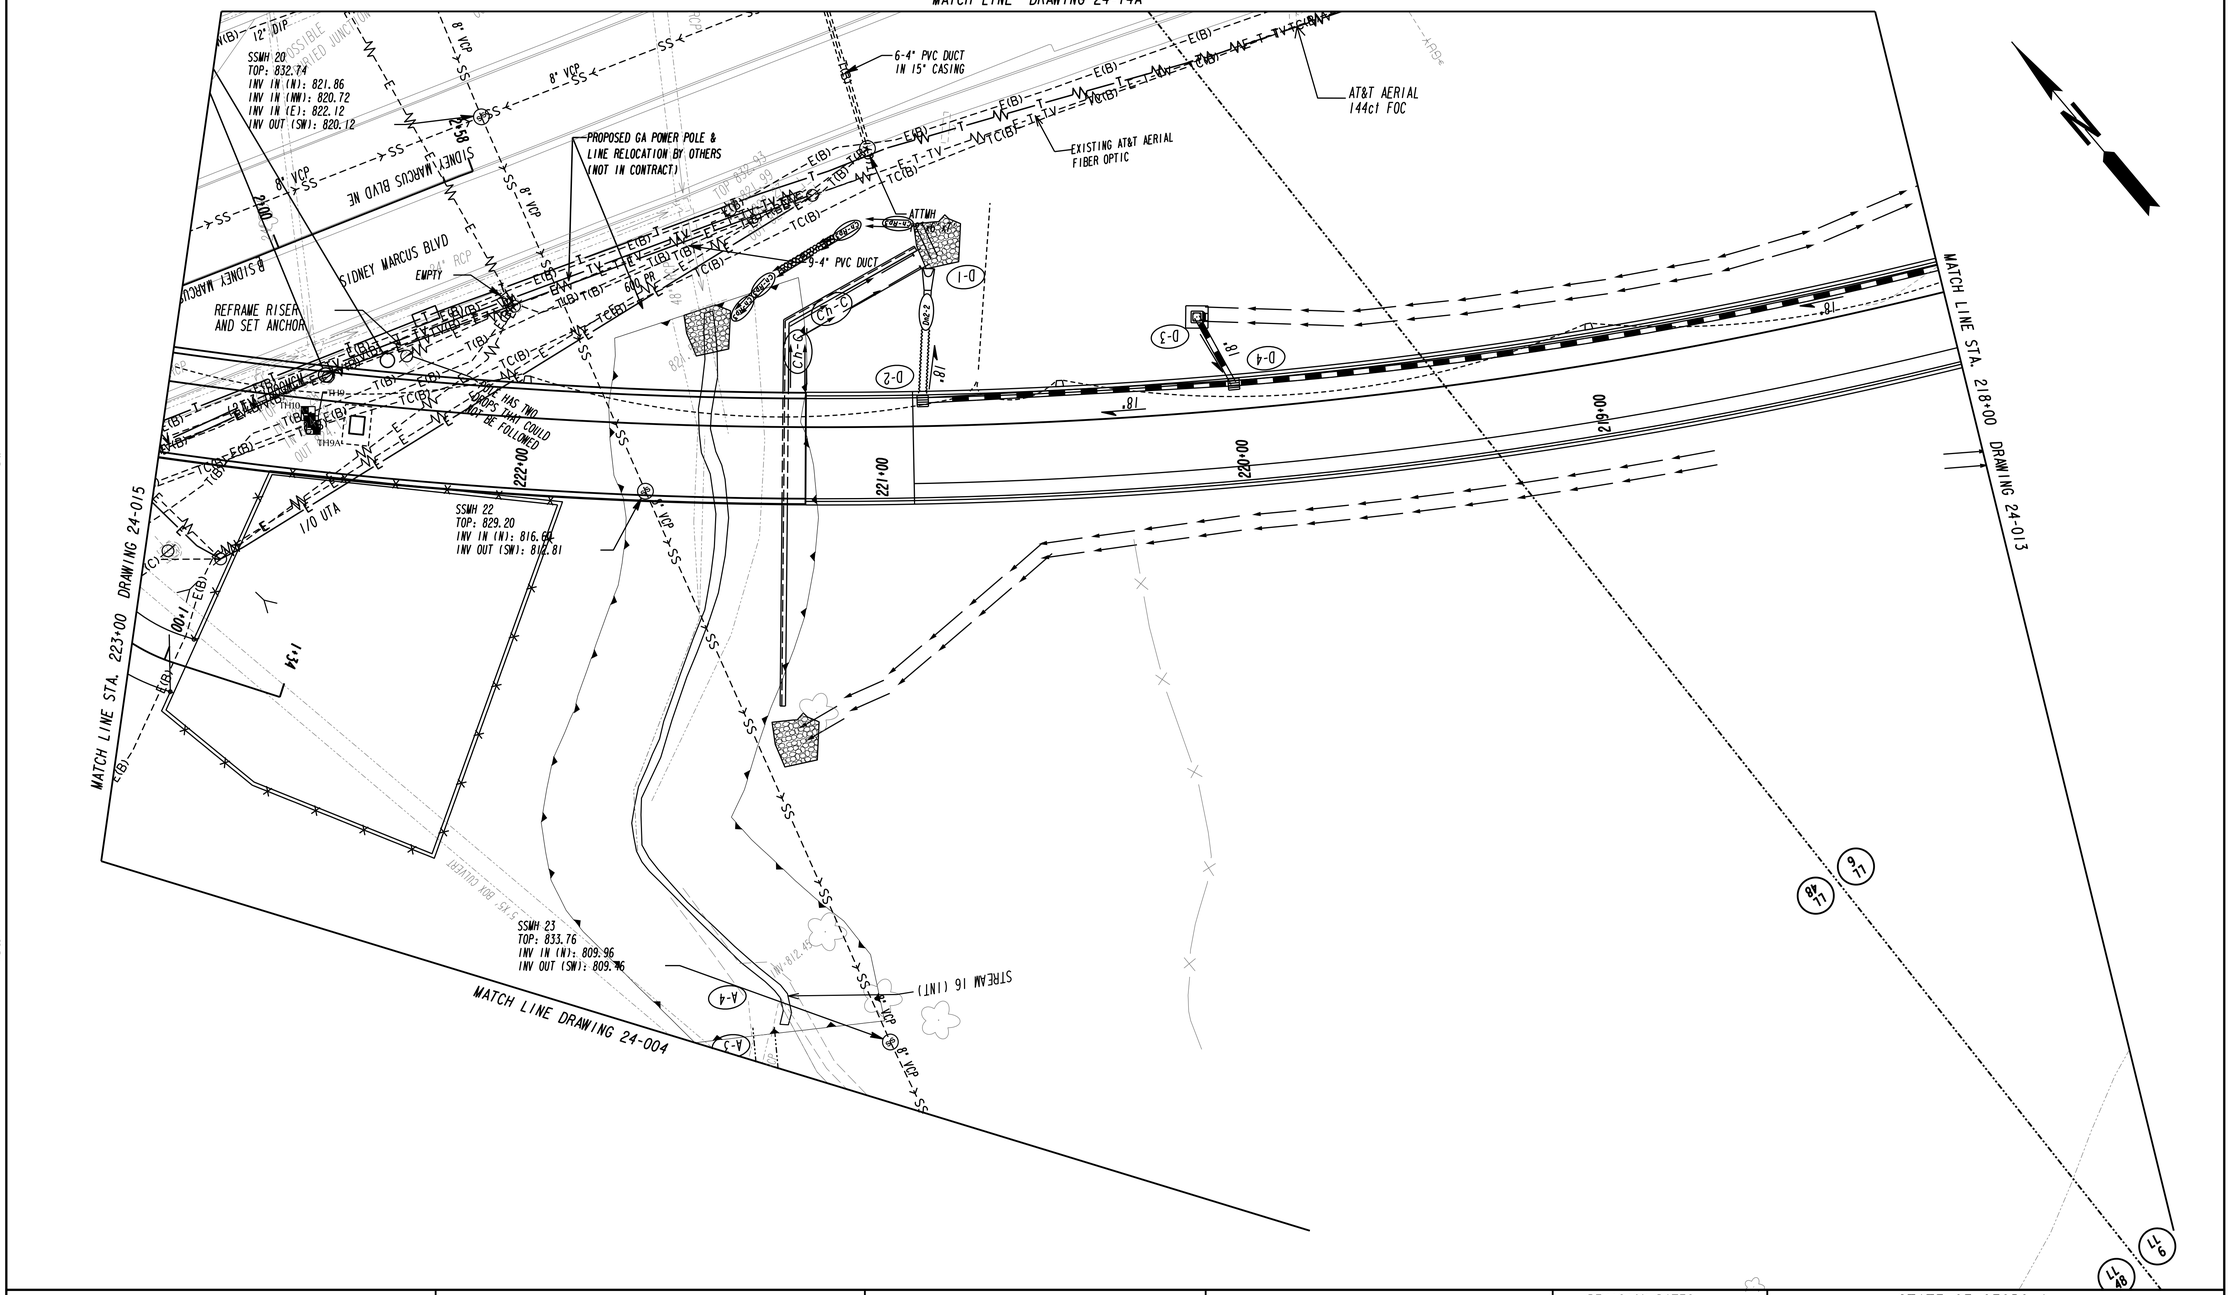

AS BUILT

Archer Western Contractors

Heath & Lineback Engineers INCORPORATED
2390 CANTON ROAD, BUILDING 200
MARIETTA, GEORGIA 30066-5393
(770)424-1668

SCALE IN FEET
0 20 40 80

Columbia Engineering
LAND PLANNERS • CIVIL ENGINEERS • LANDSCAPE ARCHITECTS • SURVEYORS

REVISION DATES

STATE OF GEORGIA
DEPARTMENT OF TRANSPORTATION
OFFICE: INNOVATIVE PROGRAM DELIVERY

UTILITY PLANS

S.R. 400/ I-85
CONNECTOR RAMPS

DRAWING No. 24-014

3/1/2007 GPLN