DATE$$$ $USER$	PRF $$PENTABLE$$	DGN GRWCOV	STATE	PROJECT NUMBER	SHEET NO.	TOTAL SHEETS
			GA	NH000-0085-02(153)	439	480

DEPARTMENT OF TRANSPORTATION
STATE OF GEORGIA

EROSION, SEDIMENT, & POLLUTION CONTROL PLAN

24 HOUR CONTACT

NAME: Karen Privett

PHONE: (770) 231-2654

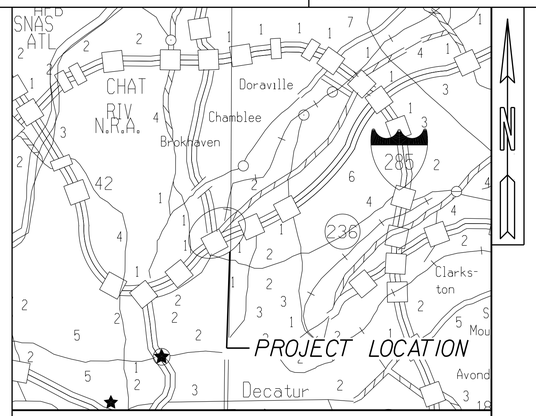

LOCATION SKETCH

SR 400 / INTERSTATE 85 CONNECTOR RAMPS
FULTON AND DEKALB COUNTIES

FEDERAL AID PROJECT
NH000-0085-02(153)

FEDERAL ROUTE * 85

STATE ROUTE * 400 & 403

P.I.NO. 762380

MID-POINT COORDINATES
N = 1390829.82
E = 2238152.64
LAT 33° 49' 24"
LONG 84° 21' 33"

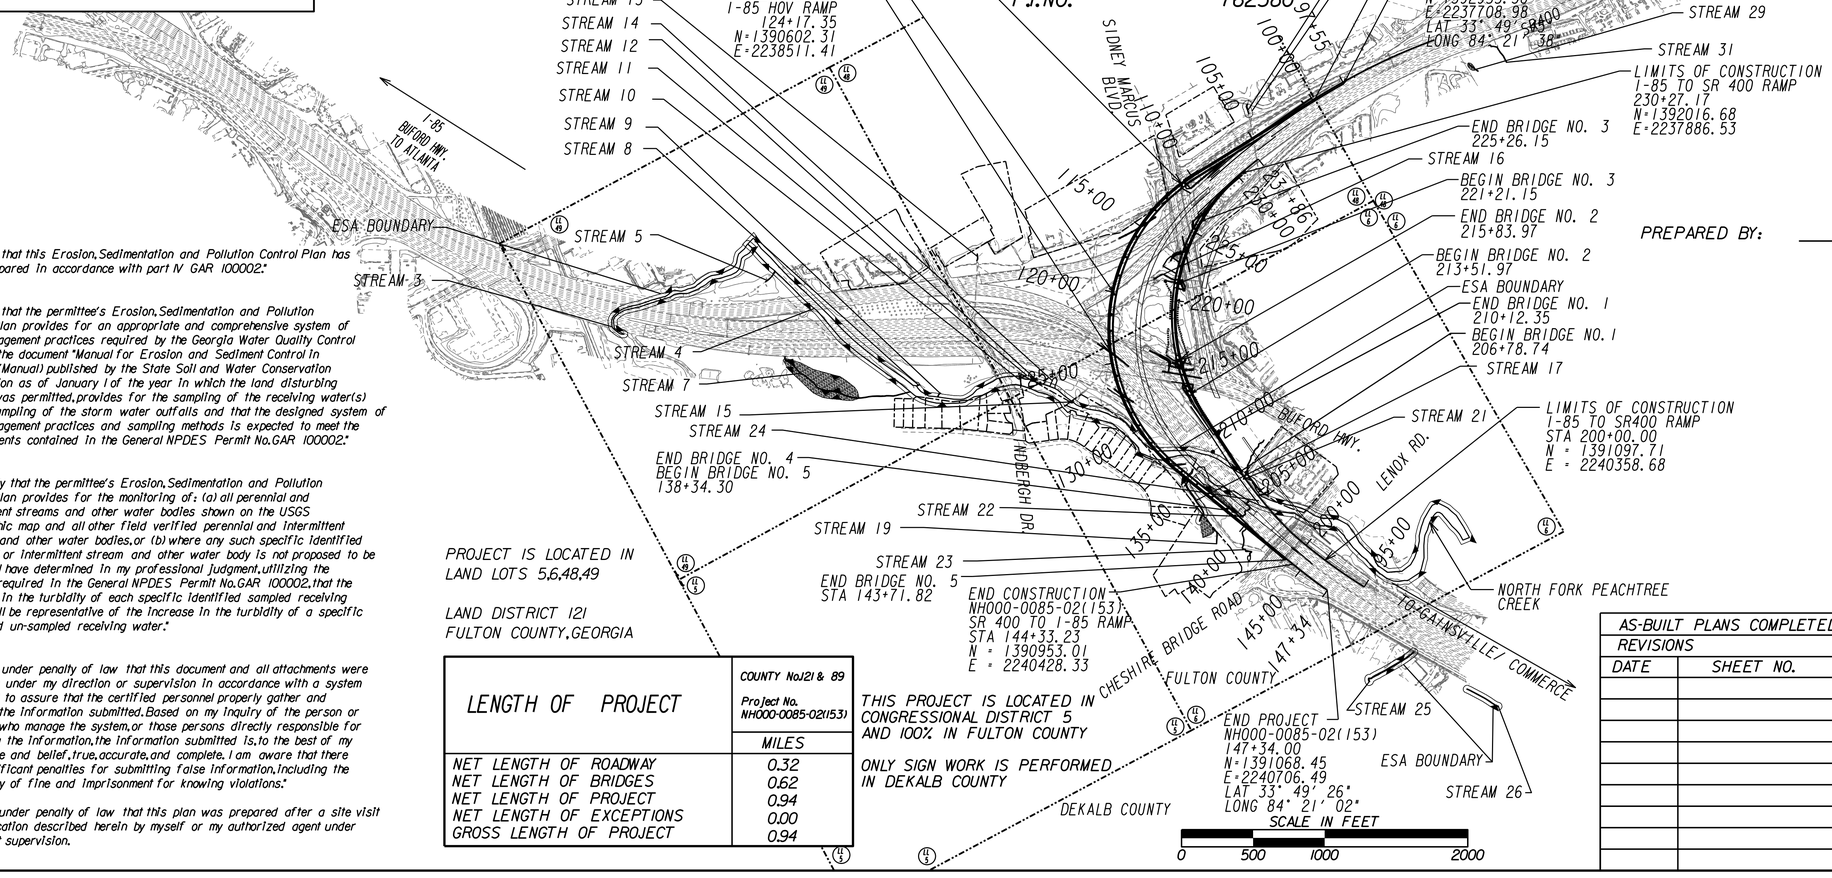

PROJECT IS LOCATED IN
LAND LOTS 5,6,48,49

LAND DISTRICT 121
FULTON COUNTY, GEORGIA

THIS PROJECT IS LOCATED IN CONGRESSIONAL DISTRICT 5 AND 100% IN FULTON COUNTY

ONLY SIGN WORK IS PERFORMED IN DEKALB COUNTY

LENGTH OF PROJECT	COUNTY No.121 & 89 Project No. NH000-0085-02(153) MILES
NET LENGTH OF ROADWAY	0.32
NET LENGTH OF BRIDGES	0.62
NET LENGTH OF PROJECT	0.94
NET LENGTH OF EXCEPTIONS	0.00
GROSS LENGTH OF PROJECT	0.94

"I certify that this Erosion, Sedimentation and Pollution Control Plan has been prepared in accordance with part IV GAR 100002."

"I certify that the permittee's Erosion, Sedimentation and Pollution Control Plan provides for an appropriate and comprehensive system of best management practices required by the Georgia Water Quality Control Act and the document "Manual for Erosion and Sediment Control in Georgia" (Manual) published by the State Soil and Water Conservation Commission as of January 1 of the year in which the land disturbing activity was permitted, provides for the sampling of the receiving water(s) or the sampling of the storm water outfalls and that the designed system of best management practices and sampling methods is expected to meet the requirements contained in the General NPDES Permit No. GAR 100002."

"I certify that the permittee's Erosion, Sedimentation and Pollution Control Plan provides for the monitoring of: (a) all perennial and intermittent streams and other water bodies shown on the USGS topographic map and all other field verified perennial and intermittent streams and other water bodies, or (b) where any such specific identified perennial or intermittent stream and other water body is not proposed to be sampled, I have determined in my professional judgment, utilizing the factors required in the General NPDES Permit No. GAR 100002, that the increase in the turbidity of each specific identified sampled receiving water will be representative of the increase in the turbidity of a specific identified un-sampled receiving water."

"I certify under penalty of law that this document and all attachments were prepared under my direction or supervision in accordance with a system designed to assure that the certified personnel properly gather and evaluate the information submitted. Based on my inquiry of the person or persons who manage the system, or those persons directly responsible for gathering the information, the information submitted is, to the best of my knowledge and belief, true, accurate, and complete. I am aware that there are significant penalties for submitting false information, including the possibility of fine and imprisonment for knowing violations."

I certify under penalty of law that this plan was prepared after a site visit to the location described herein by myself or my authorized agent under my direct supervision.

GSWCC GEORGIA SOIL AND WATER CONSERVATION COMMISSION

Thomas N. Barwick
Level II Certified Design Professional

CERTIFICATION NUMBER 0000007190

ISSUED 03/17/09 EXPIRES 03/17/15

Archer Western Contractors

PREPARED BY:

Heath & Lineback Engineers INCORPORATED
2390 CANTON ROAD, BUILDING 200
MARIETTA, GEORGIA 30066-5393
(770)424-1668

AS-BUILT

AS-BUILT PLANS COMPLETED 04-17-2015

REVISIONS

DATE	SHEET NO.	REQUESTED BY	SIGNATURE & GSWCC LEVEL II #

DRAWING No. 50-001