DATE$$$	TIME$$$	PRF	DGN	STATE	PROJECT NUMBER	SHEET NO.	TOTAL SHEETS
$USER$		$$PENTABLE$$		GA	NH00-0085-02(153)	472	480

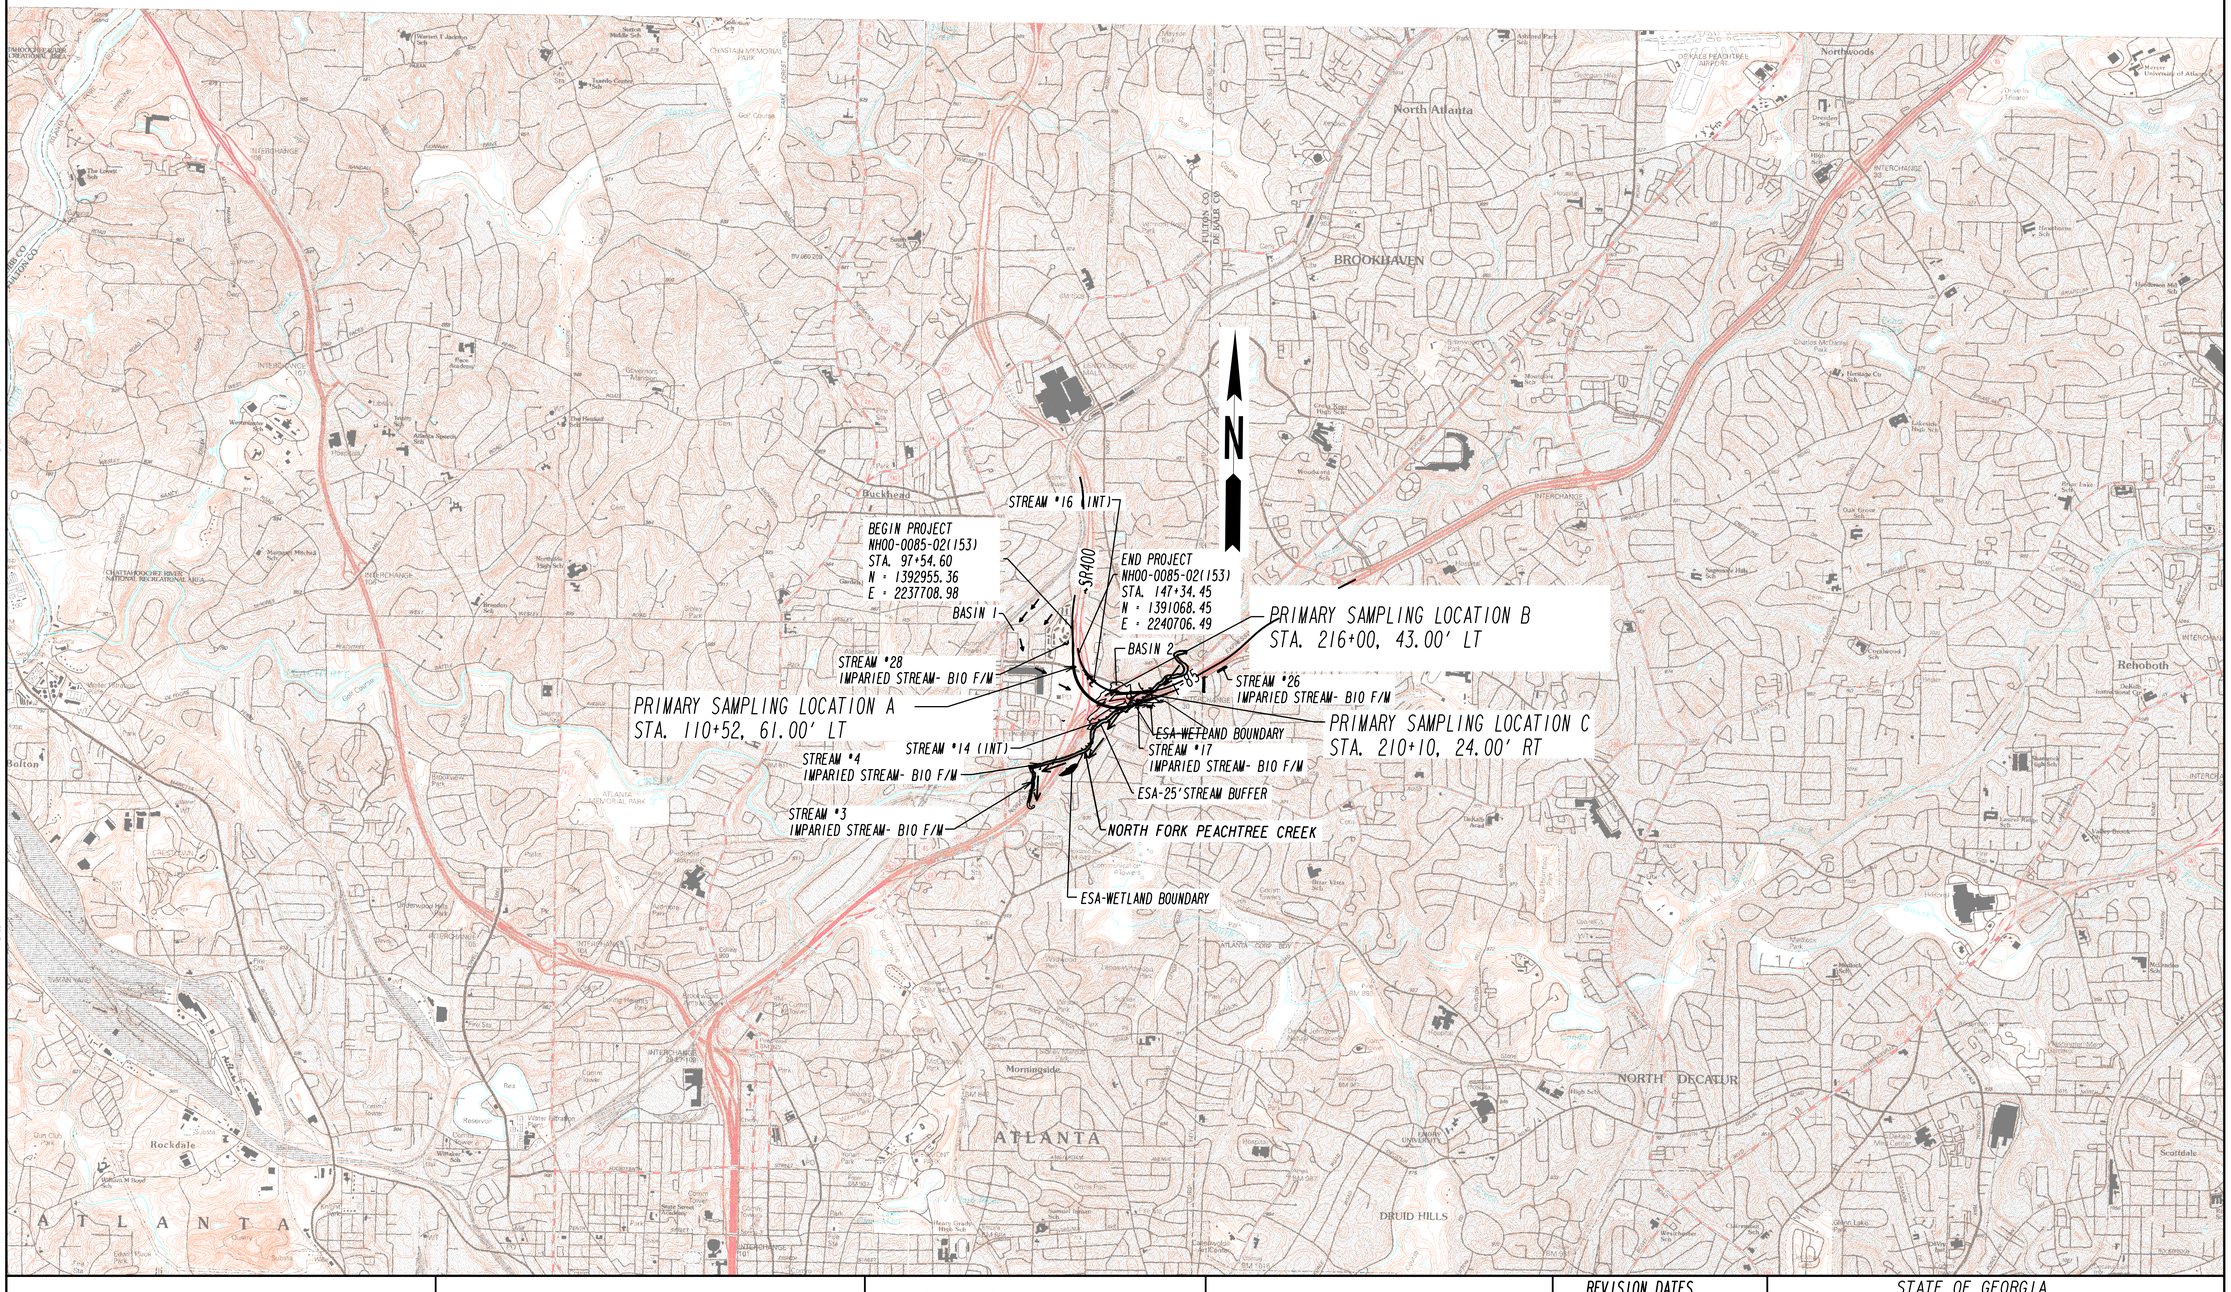

Archer Western Contractors

Heath & Lineback Engineers
INCORPORATED
2390 CANTON ROAD, BUILDING 200
MARIETTA, GEORGIA 30066-5393
(770)424-1668

SCALE IN FEET
0 2000 4000 8000

AS-BUILT

REVISION DATES

STATE OF GEORGIA
DEPARTMENT OF TRANSPORTATION
OFFICE: INNOVATIVE PROGRAM DELIVERY

WATERSHED MAP AND SITE MONITORING LOCATION

S.R. 400/ I-85
CONNECTOR RAMPS

DRAWING No.
55-001

3/1/2007 GPLN