Coweta County

FED. ROAD DIV. NO.	STATE	FED. AID PROJ. NO.	FISCAL YEAR	SHEET NO.	TOTAL SHEETS
3	GA.	I-85-1 (38)41	68	34	43

Rev. 6-4-68
Rev. 4-1-69

GRASSING DETAILS FOR ROADWAY
SCALE: 1"=10'-0"

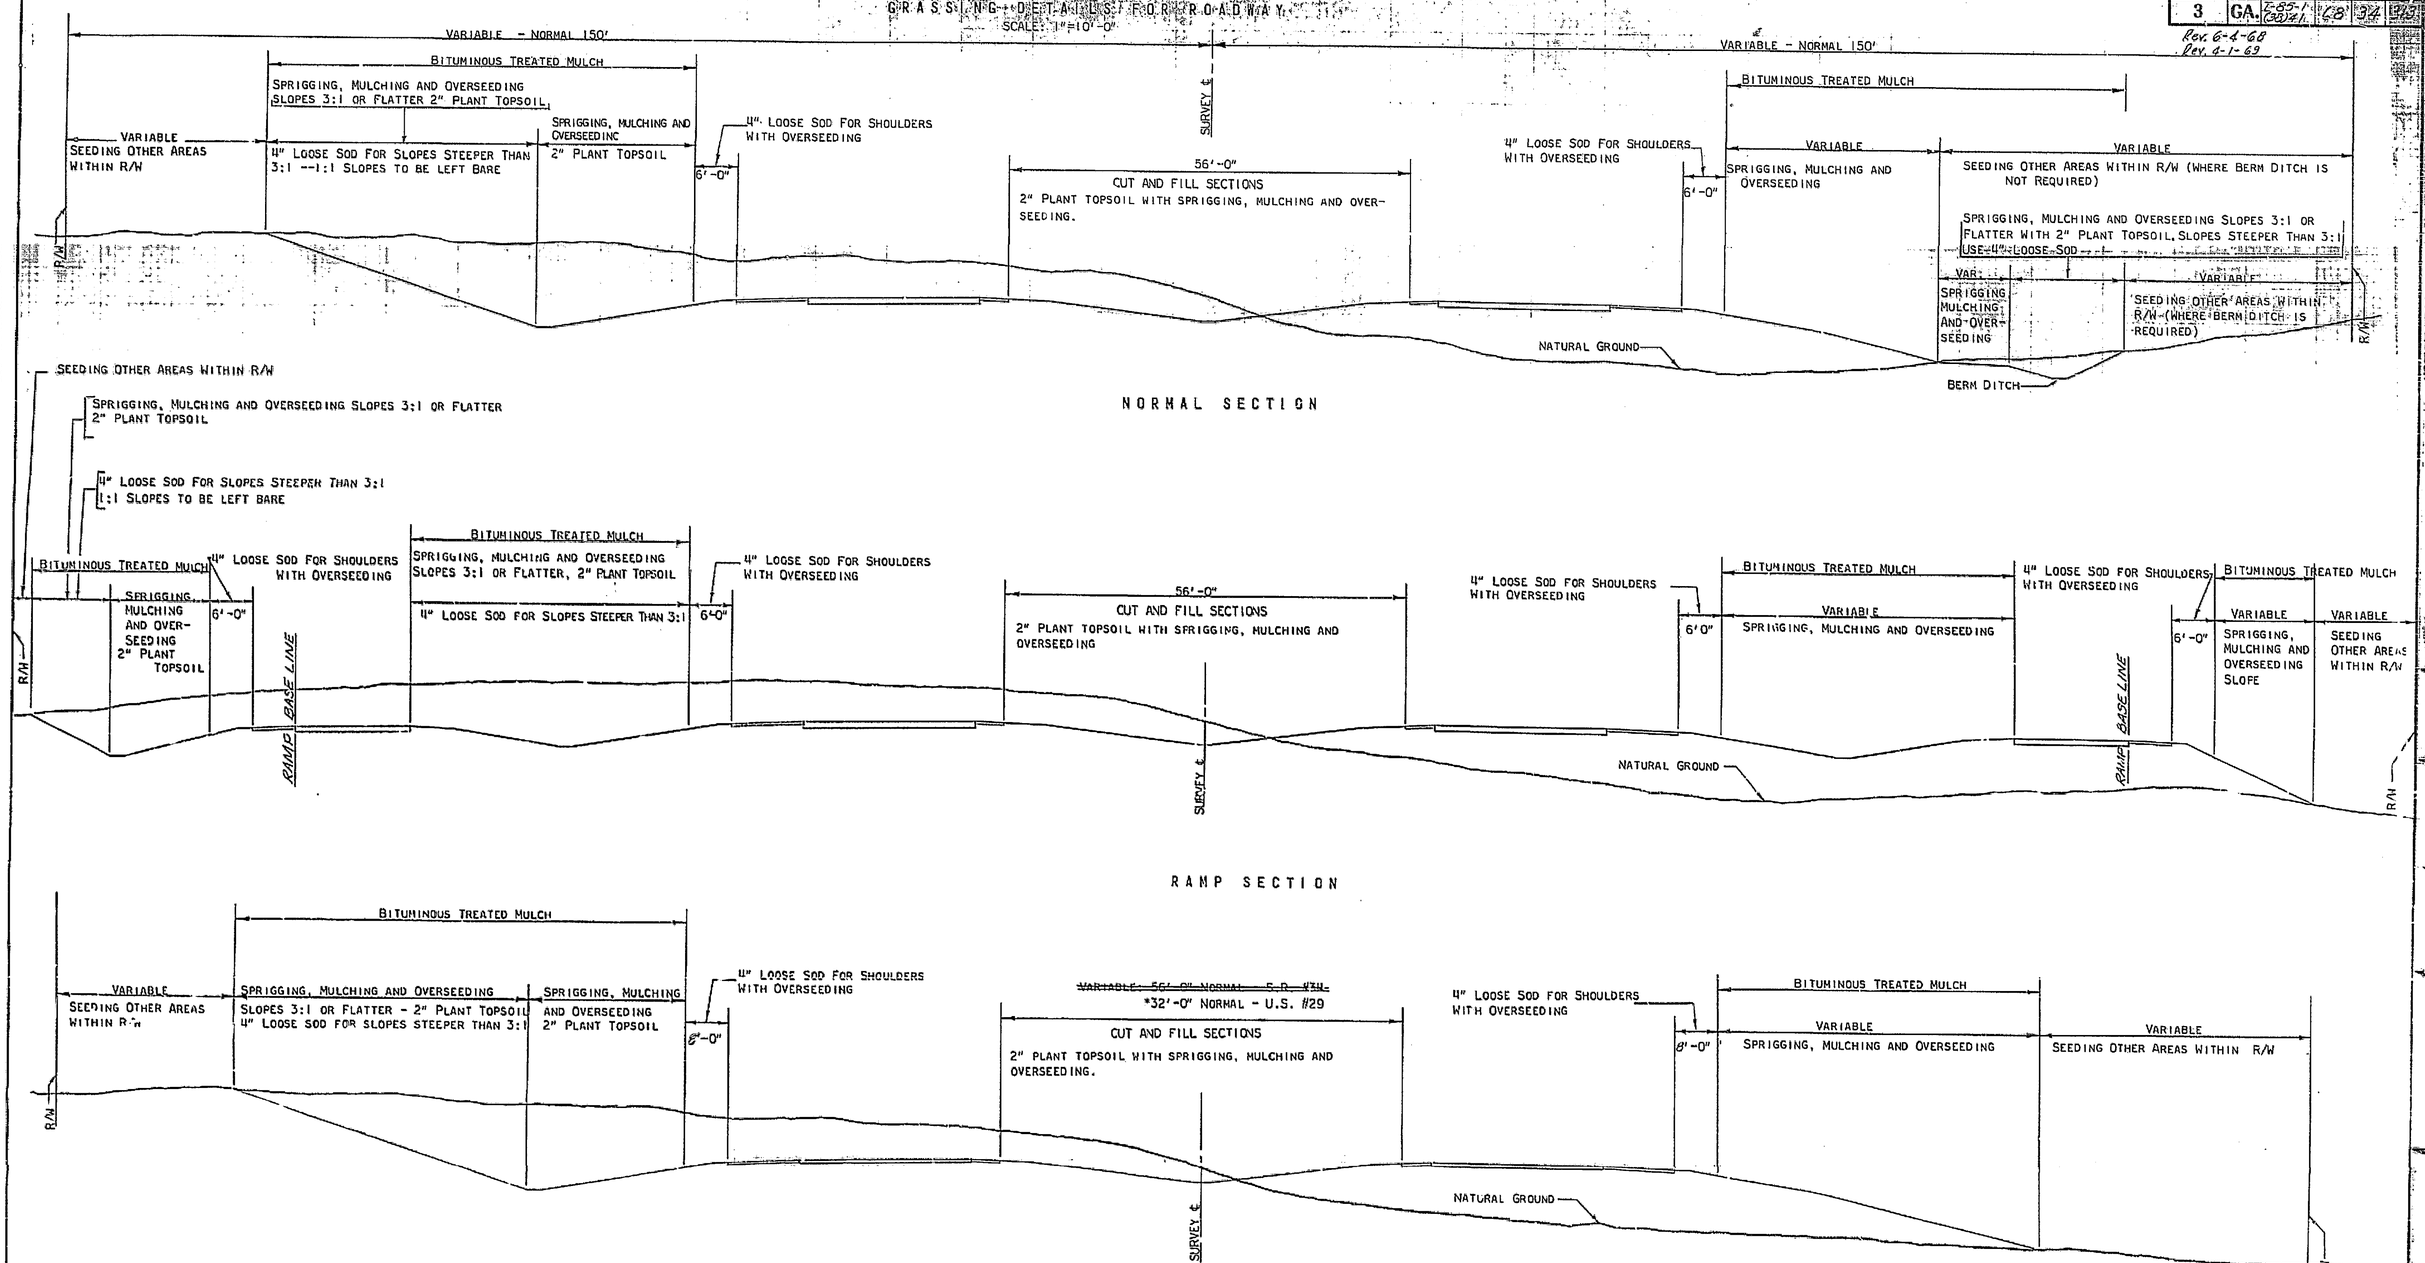

APPLICABLE AT: ~~S.R. #34~~
*U.S.#29 (STA. 53+89.31 TO STA. 85+54.60)

GRASSING OF FILL SLOPES AND BACK SLOPES REQUIRED AS SOON AS THESE AREAS HAVE BEEN CONSTRUCTED AND DRESSED. SEE SPECIAL PROVISION.

GRASSING DETAILS

MAIN LINE, RAMPS, ~~S.R. #34~~ AND U.S. #29

8.5"
11"
17"
22"
34"