FED. ROAD DIV. NO.	STATE	FED. AID PROJ. NO.	FISCAL YEAR	SHEET NO.	TO SHEET
3	GA.	F-013-1(3)	1954	22	225

Rev. Jan. 5, 1955
Rev. Nov. 5, 1956

OMIT
~~Lt. Fr. Rd.~~
~~Rt. Sta. 509+00~~
~~D = 1°26'~~
~~T = 100.00~~
~~L = 200.00~~
~~R = 3997.38'~~

OMIT
~~Lt. Fr. Rd.~~
~~Rt. Sta. 511+00~~
~~D = 1°26'~~
~~T = 100.00~~
~~L = 200.00~~
~~R = 3997.38'~~

OMIT
~~Rt. Fr. Rd.~~
~~Rt. Sta. 520+00~~
~~Δ = 9°00' Lt.~~
~~D = 5°34'44"~~
~~T = 131.8~~
~~L = 261.0~~
~~R = 2219.17'~~

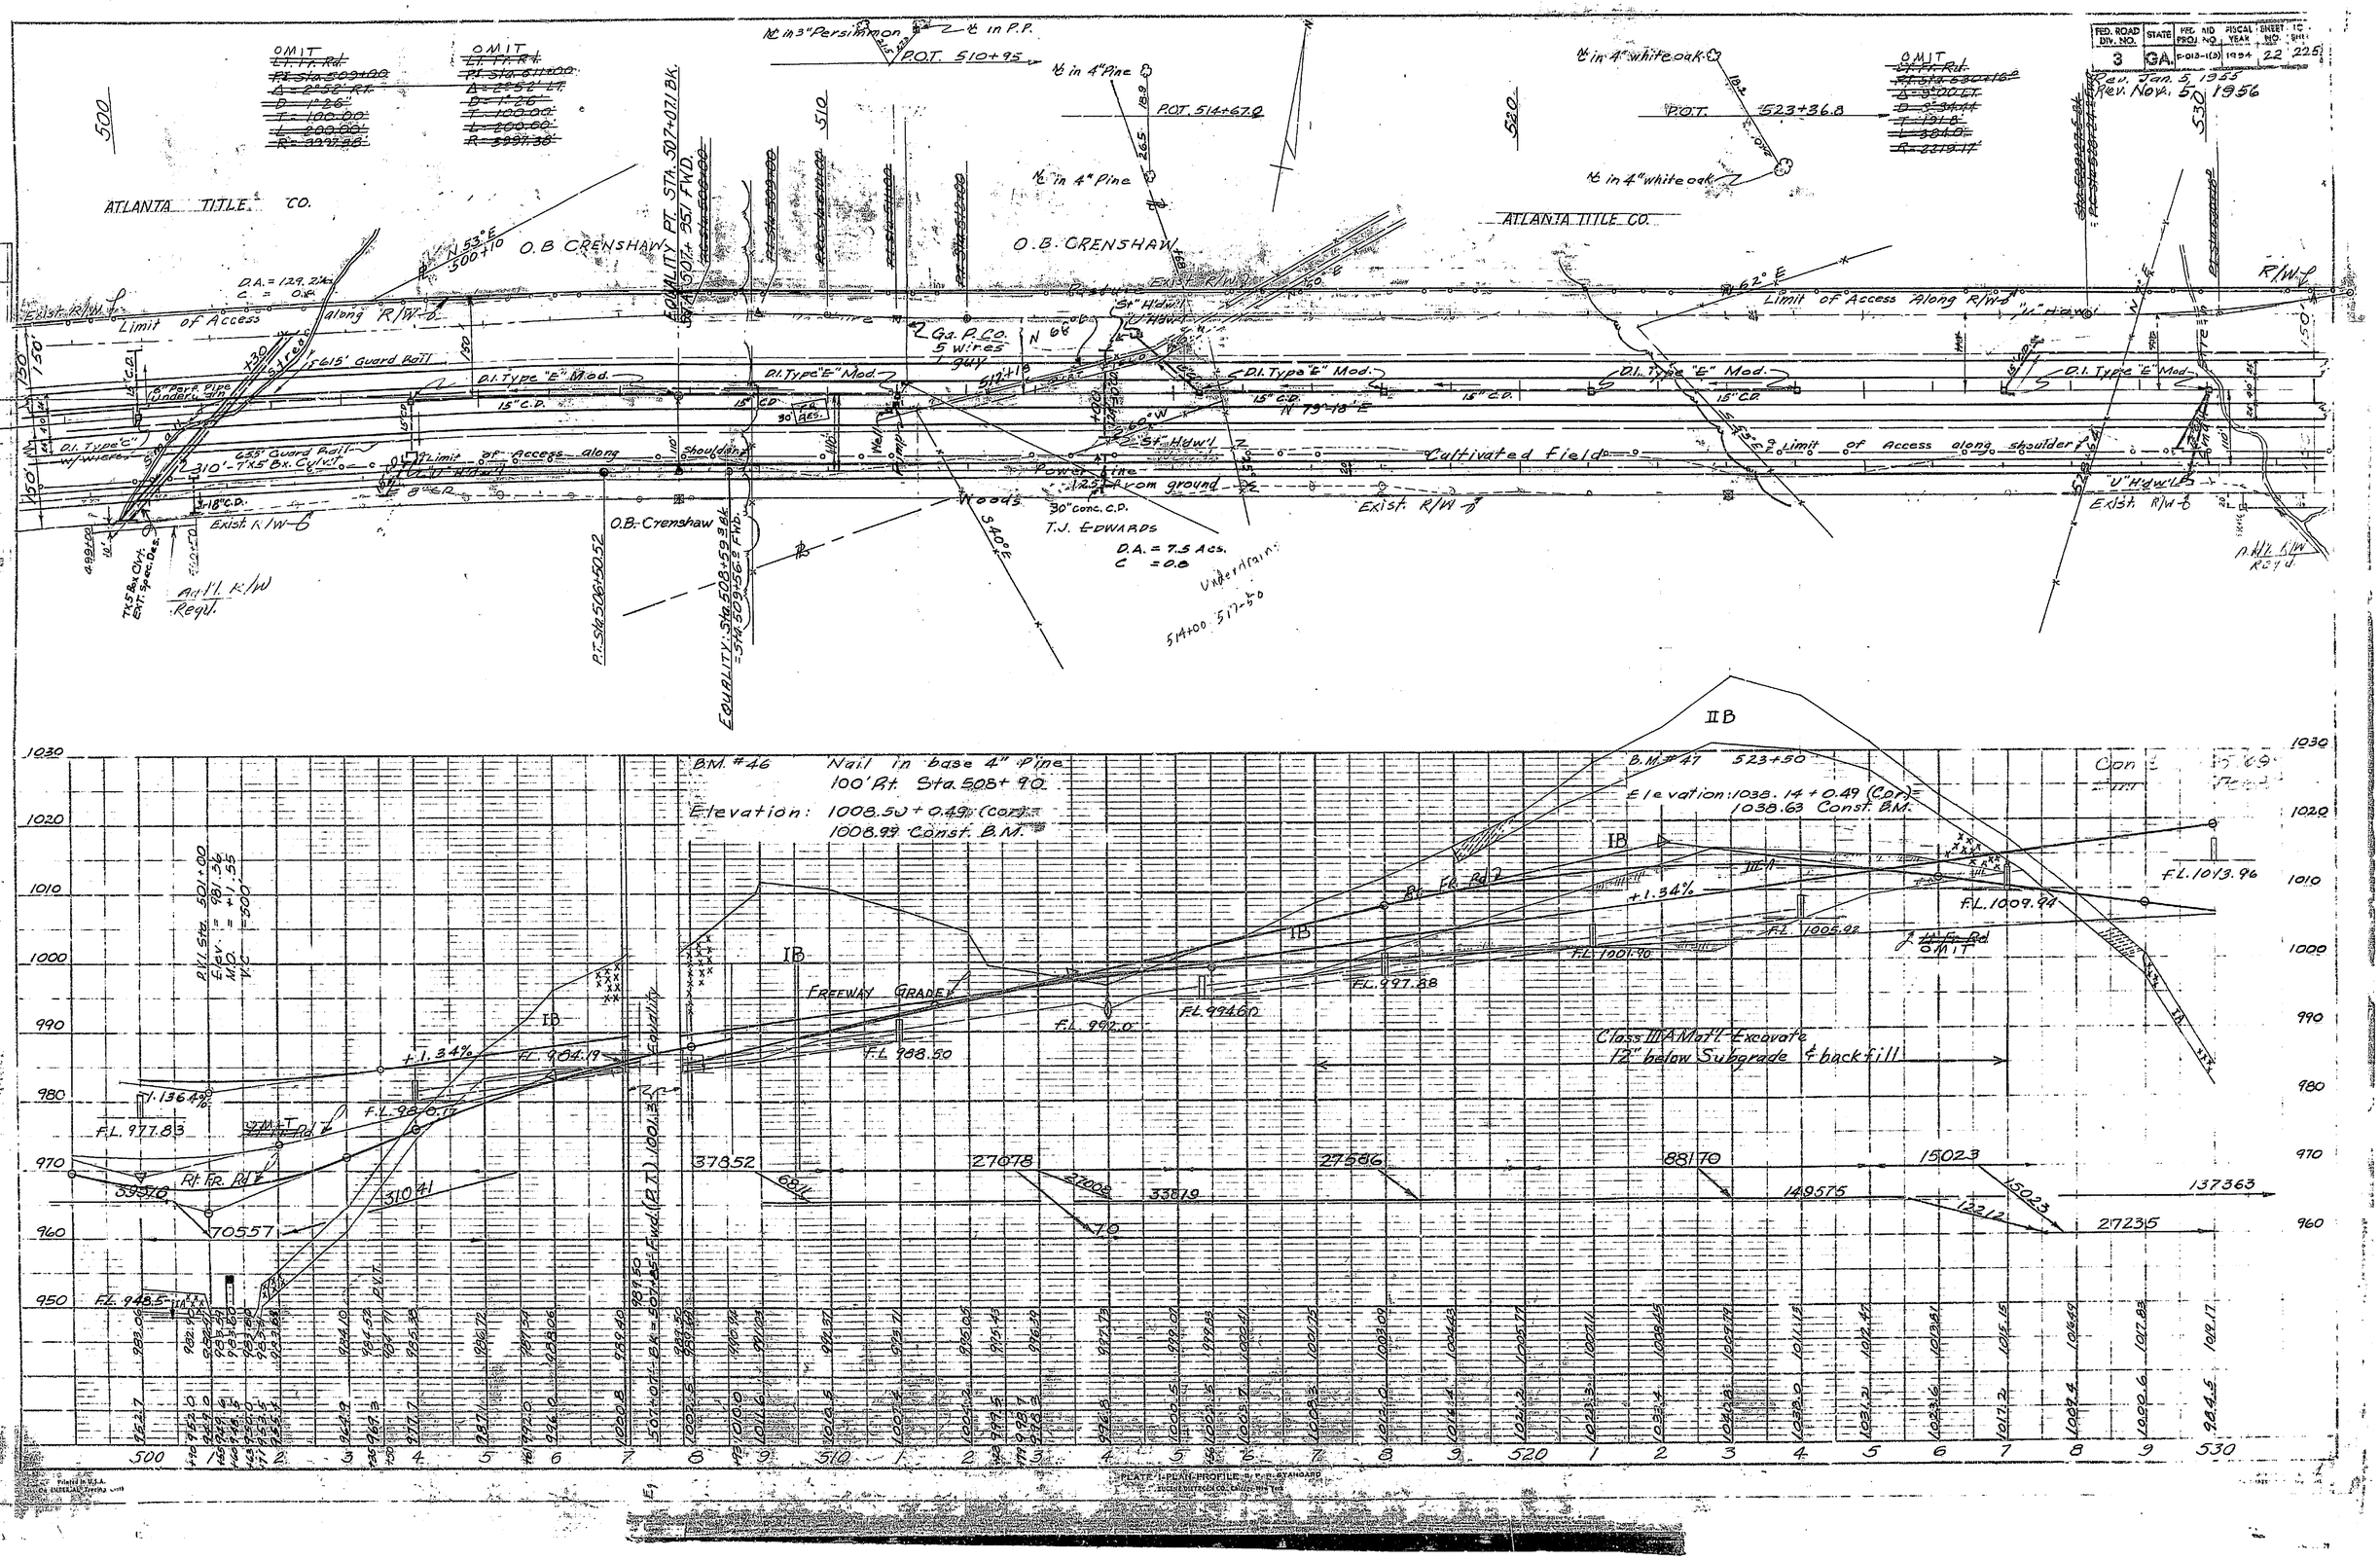

PLAN
PROFILE
PLATE 1 - PLAN-PROFILE - 3 F.R.B. STANDARD